

TOWNSHIP OF HAMPTON

RESOLUTION NO. 932

A RESOLUTION OF THE TOWNSHIP OF HAMPTON, COUNTY OF ALLEGHENY, COMMONWEALTH OF PENNSYLVANIA, ADOPTING AND ACCEPTING FOR PUBLIC DEDICATION THOSE CERTAIN "AS-BUILT" SANITARY LINES AS DESCRIBED HEREIN, AS CONSTRUCTED IN THE CROSS CREEK PLAN OF LOTS.

WHEREAS, pursuant to prior Township Approval, Developer caused to be constructed sanitary sewer lines and associated improvements to service the properties located within the Cross Creek Plan, including those sanitary sewer lines and associated easements and/or rights-of-way, as depicted in the attached "*Sanitary & Storm Sewer As-Builts for the Cross Creek Development*", situate in the Township of Hampton, Allegheny County, Pennsylvania, prepared by KU resources Inc. with final revision date of February 19, 2015", attached hereto as Exhibit "A" hereof, all of which are located within such easements and rights-of-way as established by the recorded Plan;

WHEREAS, upon completion of construction of said sewers, the Township Engineer has examined and approved said sanitary sewer "As-Builts" and has thus recommended formal acceptance of said specified proposed public portion(s) of said sanitary sewers for public ownership and maintenance, as reflected in the as-built Drawings attached hereto as Exhibit "A" hereof.

NOW, THEREFORE, Be it Resolved and adopted by the Township of Hampton, Allegheny County, Commonwealth of Pennsylvania, as follows:

Article I. That the Township of Hampton does hereby accept for dedication to the public, as public improvements of the Township of Hampton, for ownership and maintenance by the Township of Hampton, those certain described sanitary sewers and associated easements and rights-of-way "as-built" in the Cross Creek Plan of Lots, including only those sanitary sewer lines or portions thereof as depicted in the attached Exhibit "A" hereof.

Article II. This RESOLUTION shall take effect immediately in accordance with the law.

IN WITNESS WHEREOF, the present Resolution has been duly adopted by a unanimous vote of the Township of Hampton Council in public session duly convened this 22nd day of April, 2015.

ATTEST:


Township of Hampton Council



W. Christopher Lochner
Municipal Manager


Council President

EXHIBIT A

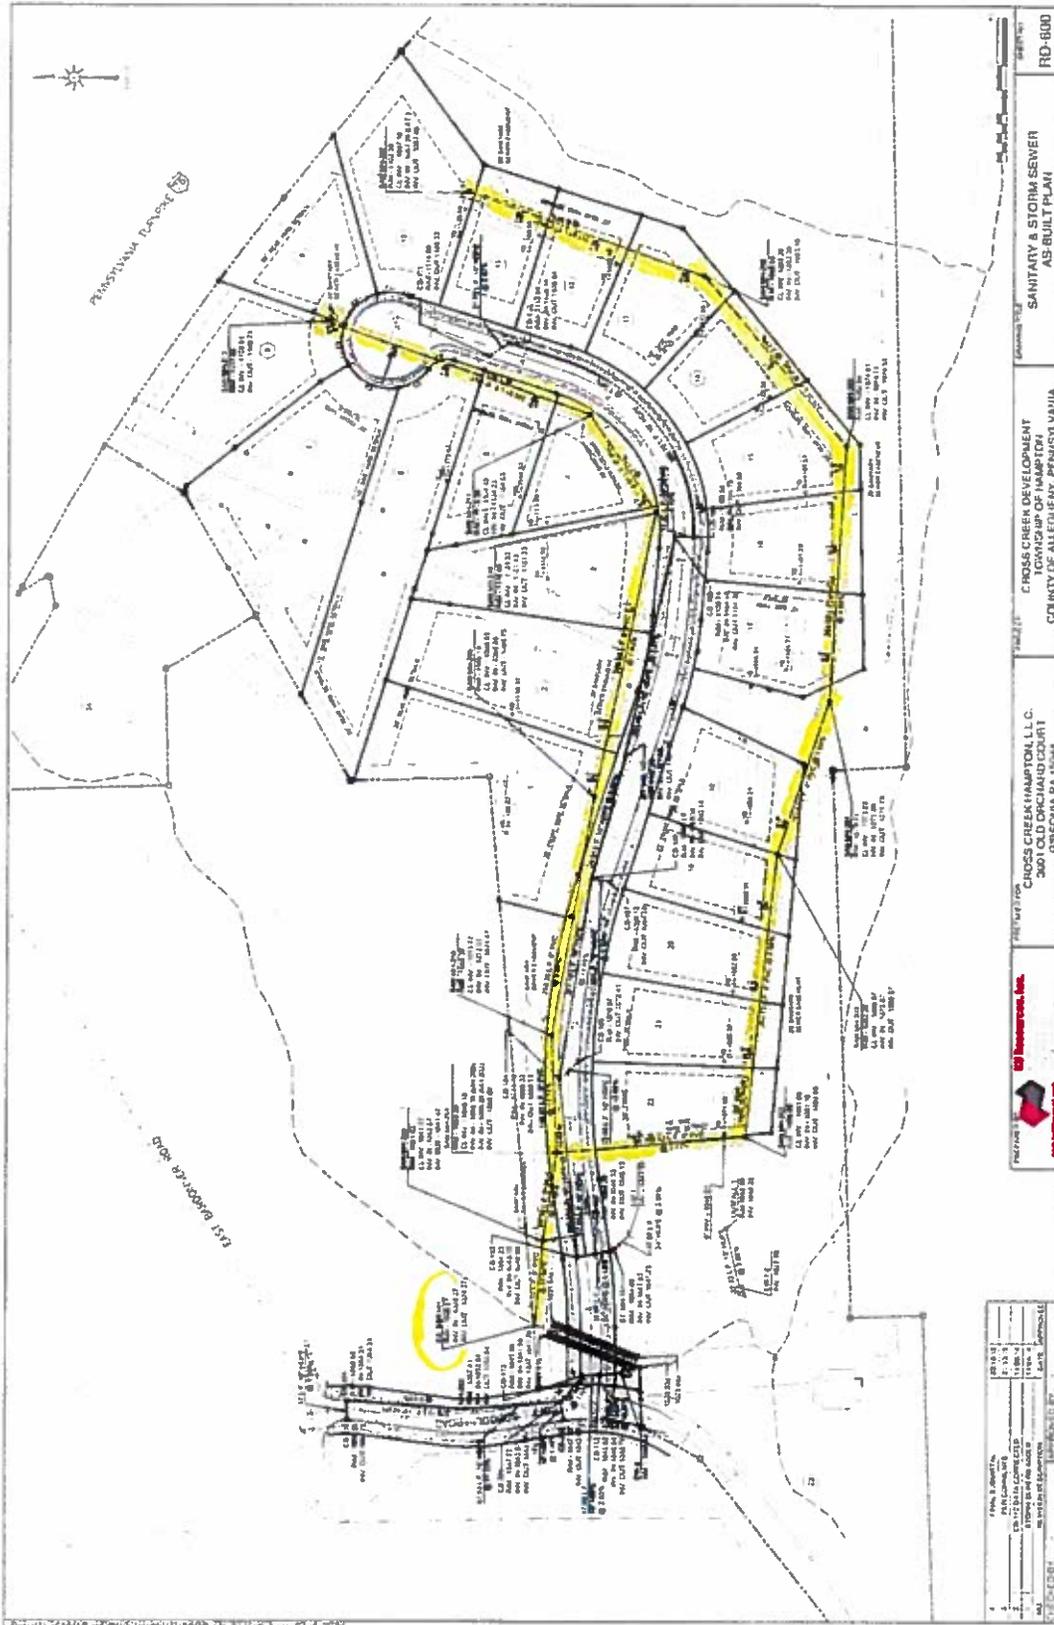

DATE	10/15/14
BY	J. J. ...
CHECKED	...
IN CHARGE	...
SCALE	AS SHOWN



FOR THE USE OF
CROSS CREEK HAMPTON, L.L.C.
 3001 OLD ORCHARD COURT
 GREENSBORO, PA 15444

FOR THE USE OF
CROSS CREEK DEVELOPMENT
 TOWNSHIP OF HAMPTON
 COUNTY OF ALLEGHENY, PENNSYLVANIA

DATE: 10/15/14
 SHEET NO.:
SANITARY & STORM SEWER
AS-BUILT PLAN
 RD-600

